


NOTICE: THIS DRAWING HAS NOT BEEN PUBLISHED AND IS THE SOLE PROPERTY OF FLUOR. AND IS LENT TO THE BORROWER FOR THEIR CONFIDENTIAL USE ONLY, AND IN CONSIDERATION OF THE LOAN OF THIS DRAWING, THE BORROWER PROMISES AND AGREES TO RETURN IT UPON REQUEST AND AGREES THAT IT WILL NOT BE REPRODUCED, COPIED, LENT, OR OTHERWISE DISPOSED OF DIRECTLY OR INDIRECTLY, NOR USED FOR ANY PURPOSE OTHER THAN THAT FOR WHICH IT IS FURNISHED.

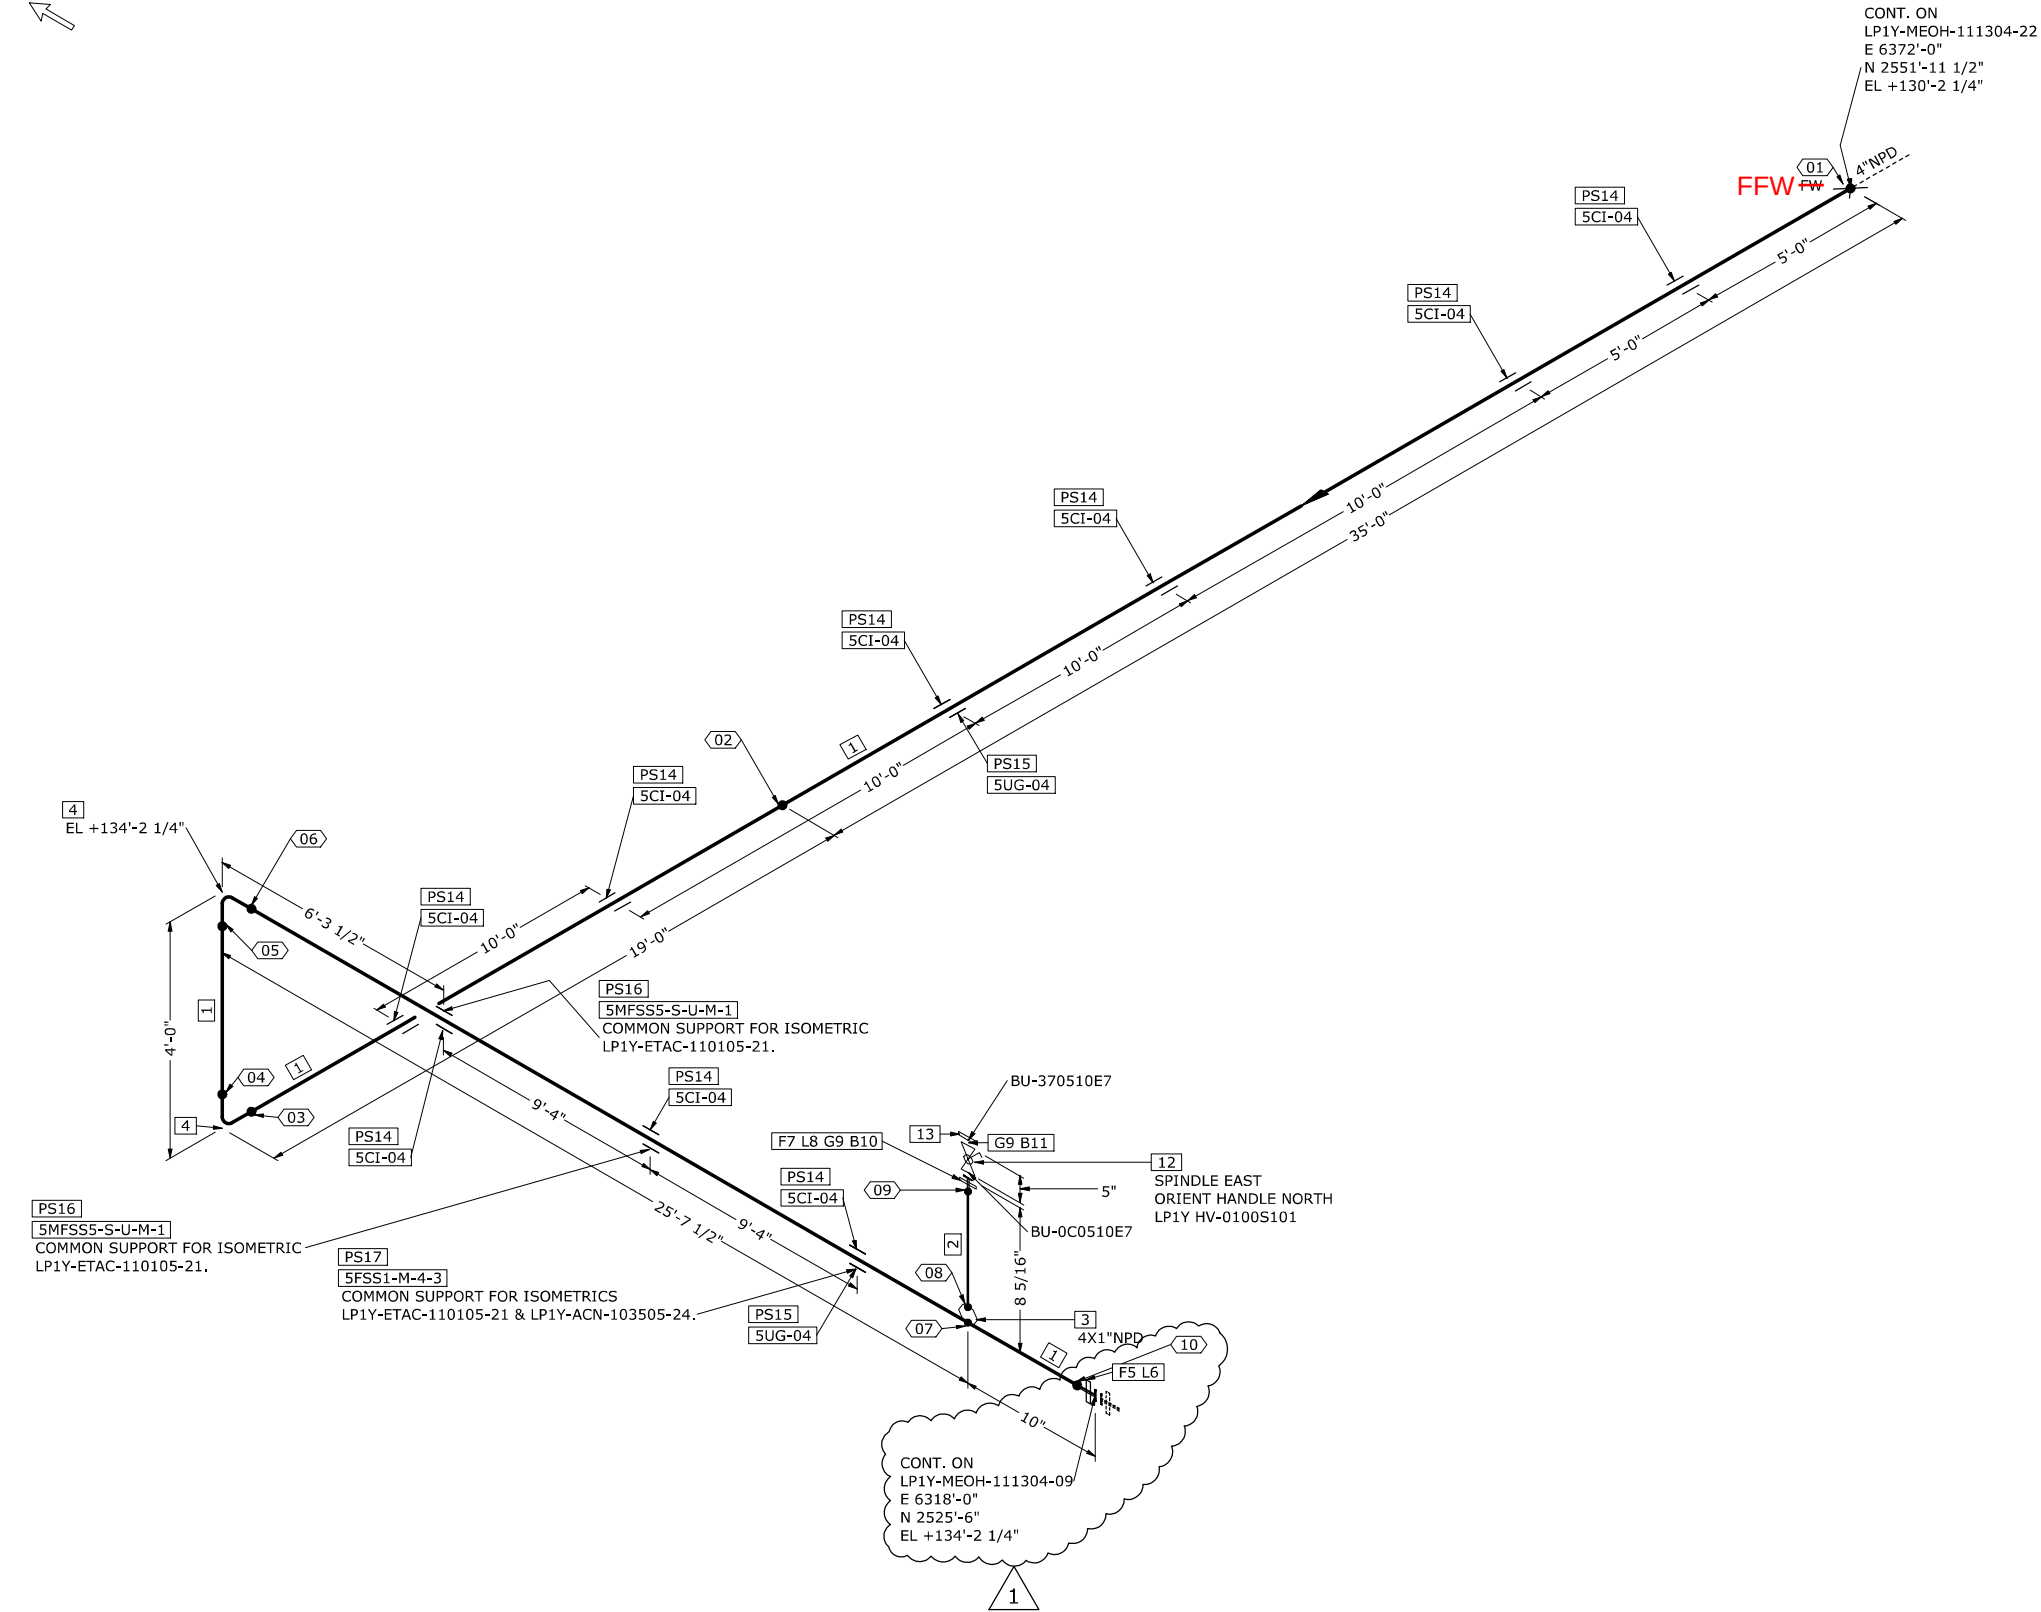

ISOMETRIC SPECIFIC NOTE:
A. CONTRACTOR TO PROVIDE ADDITIONAL PIPE LENGTH AT THE FIELD WELD CALLOUTS TO ALLOW FOR CUTBACKS AFTER THE PROOF PRESSURE TEST, IF A TEST PLUG IS NOT AVAILABLE DUE TO PIPE SIZE.

- GENERAL NOTE:
- REFER TO THE PIPING LINE LIST FOR PROCESS DATA/CONDITIONS AND OTHER FABRICATION DETAILS SUCH AS TESTING, CLEANING, AND PAINTING REQUIREMENTS.
 - UNLESS OTHERWISE NOTED, ALL WELDS ARE INDICATED AS SHOP WELDS. CONTRACTOR TO DETERMINE FIELD WELDS LOCATIONS AND DOCUMENT ACCORDINGLY ON AS-BUILT RECORDS.
 - WELDS AND/OR COUPLINGS DEFINING RANDOM PIPE SPOOL LENGTHS ARE FOR REFERENCE ONLY. FINAL WELD OR COUPLING LOCATION IS TO BE DETERMINED BY THE CONTRACTOR.
 - THE MECHANICAL CONTRACTOR TO FIELD VERIFY INTERFACE POINTS BETWEEN EQUIPMENT & PLUMBING FIXTURES IN 3rd FIX (3F SERIES CWP) AND YS YARD STICK BUILT (YS SERIES CWP EQUIPMENT CONNECTIONS) ISOMETRICS PRIOR TO FABRICATION.
 - THE MECHANICAL CONTRACTOR IS TO VERIFY ALL DIMENSIONAL DATA WITH ACTUAL FIELD CONDITIONS PRIOR TO INSTALLATION OF THE SYSTEM.
 - PIPE SUPPORTS SHALL BE FURNISHED AND INSTALLED IN ACCORDANCE WITH THIS DRAWING AND SPECIFICATION LP100-250-EMS-15110. MECHANICAL CONTRACTOR SHALL PROVIDE TEMPORARY SUPPORTS AS REQUIRED TO AID PRESSURE TESTING, INSTALLATION ETC.
 - PIPE SUPPORTS INDICATED ON THE DRAWING MAY BE PART OF AN ASSEMBLY ON SEVERAL ISOMETRICS. REFER TO THE 3D MODEL FOR THE COMPLETE PIPE SUPPORT ASSEMBLY.
 - MECHANICAL CONTRACTOR SHALL NOTE ALL DESIGN CHANGES ON THIS DRAWING AND RETURN IT TO THE CONSTRUCTION WPO FOR AS-BUILT RECORDS.
 - THE BILL OF MATERIAL IS FOR REFERENCE ONLY.
 - SLOPE EQUIVALENTS: 1:27 = 7/16" PER FT, 1:96 = 1/8" PER FT, 1:120 = 1/10" PER FT, 1:192 = 1/16" PER FT, 1:480 = 1/40" PER FT.

NODE:	TFS
BUILDING NO:	Y
CWP NO:	TFS00A108MMPP
MODULE NO:	TFS00A108MM
SERVICE CODE:	MEOH
PIPE SCHEDULE:	315
INSULATION CODE:	NI
TRACING TYPE:	NT
ELASTOMER:	P
HYGIENIC: NO	IMPACT: YES

BILL OF MATERIALS

PT NO	DESCRIPTION	NPD (IN)	CMDTY CODE	QTY
1	PIPE SCH 10S ERW 316/316L SS A312	4	5368751	82.3'
2	PIPE SCH 10S ERW 316/316L SS A312	1	5368751	0.3'
3	PIPET SCH 10S 316/316L SS	4X1	5510132	1
4	ELL 90 LR SCH 10S 316/316L SS A403-W	4	5450706	2
5	FLG LAP JOINT 150# 316 SS	4	5599578L	1
6	STUB END SCH10S 316/316L A403-W SHORT PATT	4	5450750L	1
7	FLG LAP JOINT 150# 316 SS	1	5599578L	1
8	STUB END SCH10S 316/316L A403-W SHORT PATT	1	5450750L	1
9	GASKET 150# PTFE RING 1/8" THK LOW STRESS	1	5669399L	2
10	STUD-BOLT A193 GR B8M W/A194 GR 8M NUTS - 3 in. Length	1/2	5676576L	4
11	STUD-BOLT A193 GR B8M W/A194 GR 8M NUTS - 2.75 in. Length	1/2	5676576L	4
12	BALL 150# RF 316SS TFE FP HNDL OP	1	5352193L1	1
13	FLG BLIND 150# RF 316/316L SS	1	5616520	1
14	5CI, ISOLATION CRADLE, 4" PIPE, SS	4	5CI-04	9
15	5UG, U-BOLT GUIDE FOR UNINSULATED LINES 4" PIPE	4	5UG-04	2
16	5MFSS5-S-U-M, GUIDE BRACKET, STEEL, UPRIGHT, MEDIUM SIZE	4	5MFSS5-S-U-M-1	2
17	5FSS1, FIELD SUPPORT STEEL, SIZE M, LC 4, HC 3	4	5FSS1-M-4-3	1

QC CHECKED

1	ISSUED FOR CONSTRUCTION	26-NOV-2025	IRN	CTK	RRS	N/A	MKF	
0	ISSUED FOR CONSTRUCTION	02-JUN-2025	CWG	CTK	RRS	N/A	MKF	
REV. NO.	DESCRIPTION	DATE	DRWN	CHK	STR	INSTR	QC	
Lilly		FLUOR® EFDEE Engineering PC PROJECT NO. B3LG						
LINE NUMBER		LP1Y 4" SS MEOH (315) P 111304						
REFERENCE P&ID NUMBER		ISOMETRIC DRAWING NUMBER		REV				
LP1Y-DI-60000111		LP1Y-MEOH-111304-21		1				